

B.A. Construction Services, LLC.

8 Airport Park Boulevard
Latham, NY 12110
Ph : 518-785-3005

RFI

To: Thomas Field
Clark Engineering, P.C.
20 Shaker Road
New Lebanon, NY 12125
Ph: (518) 794-8613 Fax: (518) 766-5663

RFI #: 13
Date: 5/12/2008
Job: 07-20-2046 Hoosic Valley Central School
Phone:

CC: Thomas Kenney (CS Arch, P.C.), Bruce Boice

Subject: HV01-7 - Catch Basin Specifications

Drawing: HS C-106 - Athletic Field Stormwater and
Water Main Plan

Spec Section:

Cost Impact: None

Schedule Impact: None


Request: **Date Required: 5/16/2008**
Dwg HS C-106; Field A NW corner CB between W8 and long jump pit. Please provide ID, rim, pipe sizes and inverts.

Requested by: Letha Price
B.A. Construction Services LLC

Response:
See Attached Drawing C-SK-3.

Answered by: Sarah M. Kileen
Clark Engineering, P.C.

Answered date: May 13, 2008

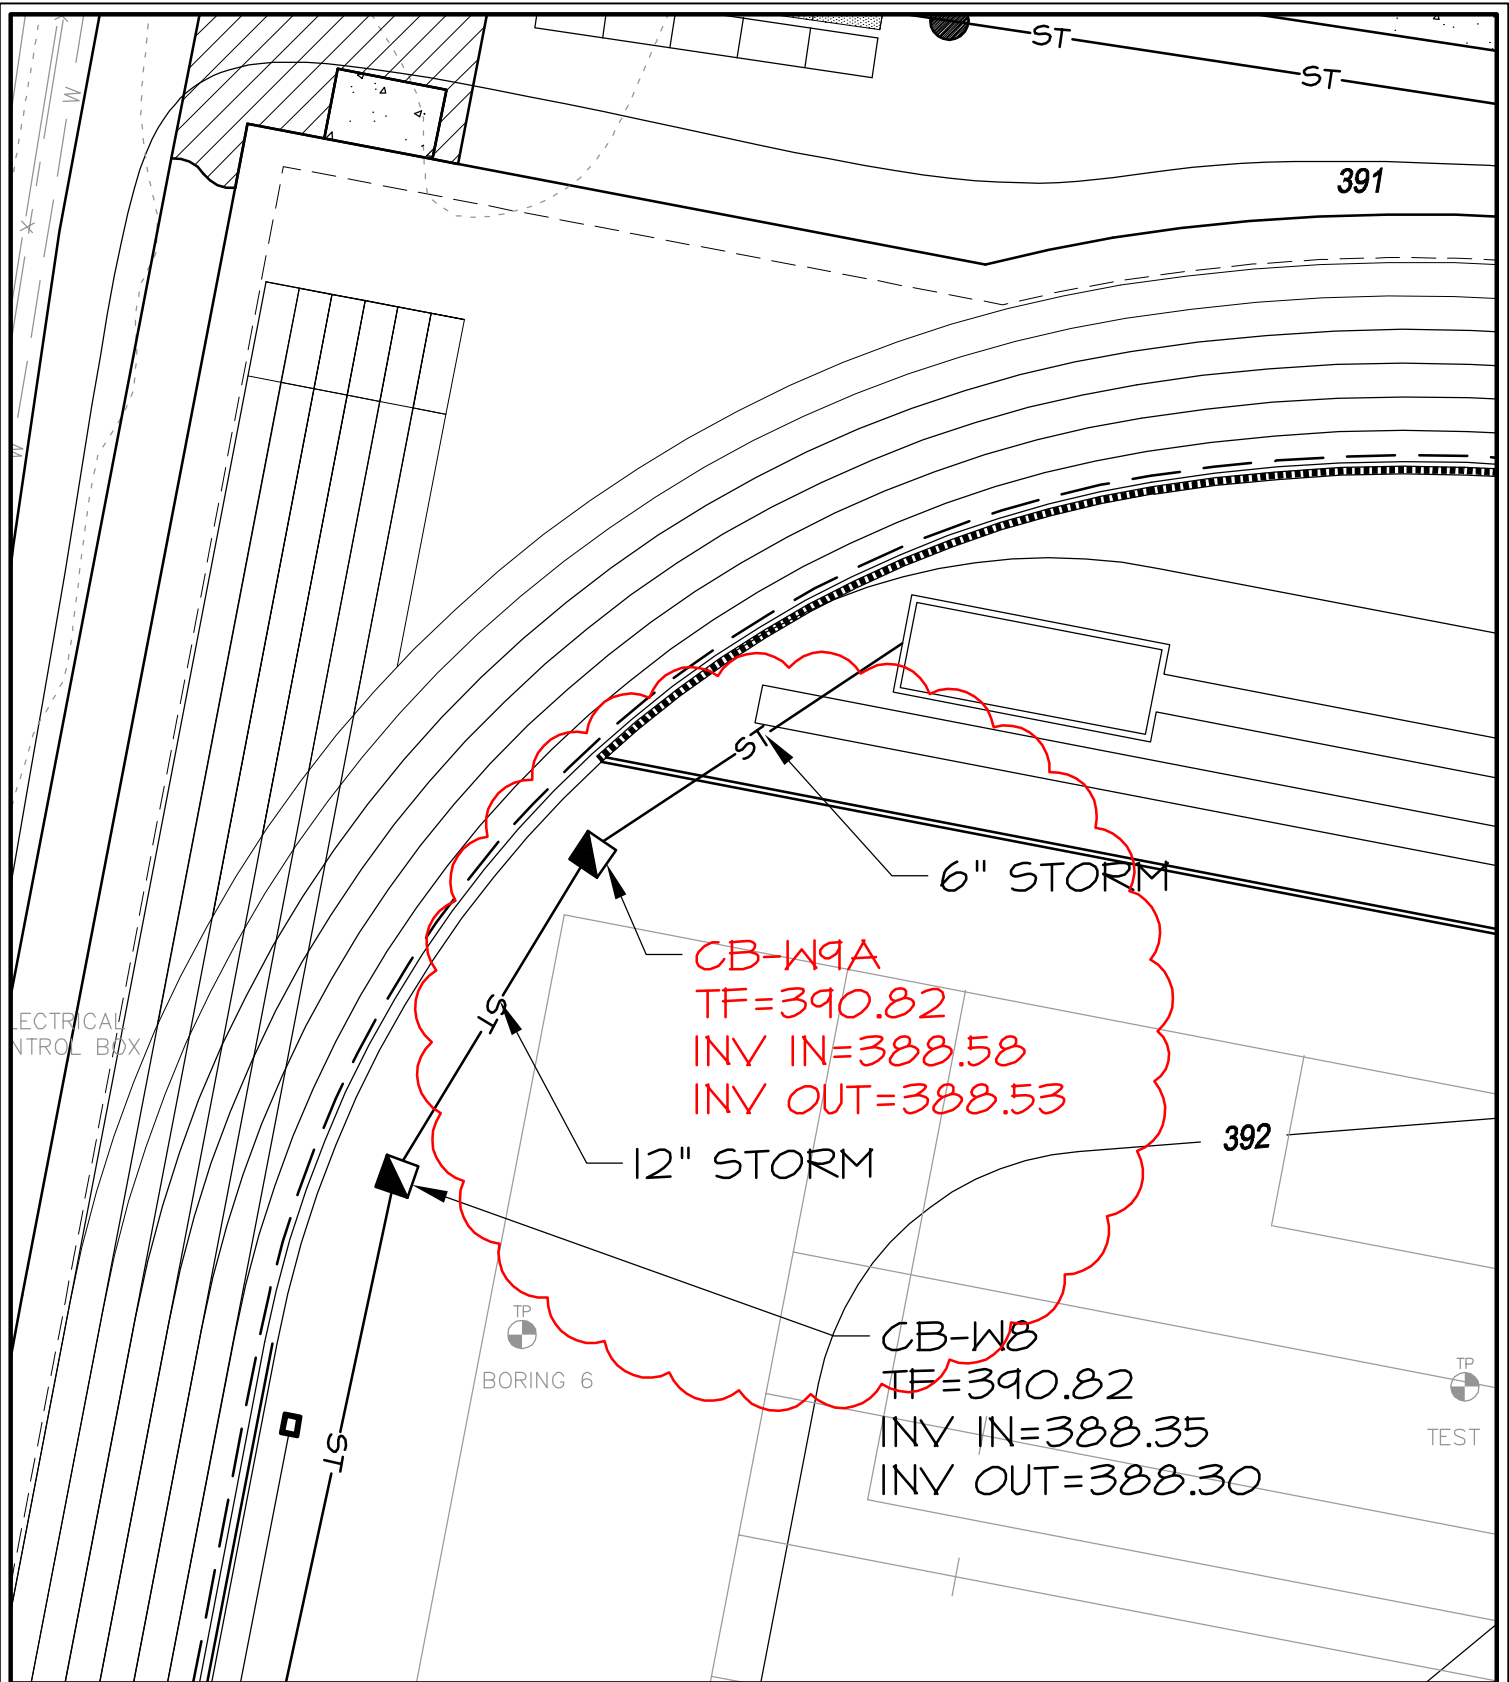

TITLE **HS C-106**
ATHLETIC FIELD STORMWATER & WATER MAIN PLAN

HOOSIC VALLEY
CSD

 SCHAGHTICOKE, NY

PROJECT No.
2540702
 DRAWING No.
C-SK-3

SCALE: **1"=20'**
 DATE: **5-13-08**
 DRAFTED BY: **SMK**
 CHECKED: **THF**
 APPROVED: **ALC**

CLARK
ENGINEERING & SURVEYING, P.C.
 20 SHAKER RD., BOX 730, NEW LEBANON, NY 12125
 TEL: (518)794-8613 FAX: (518)766-5663
 www.clarkpc.com Clark Project No.